


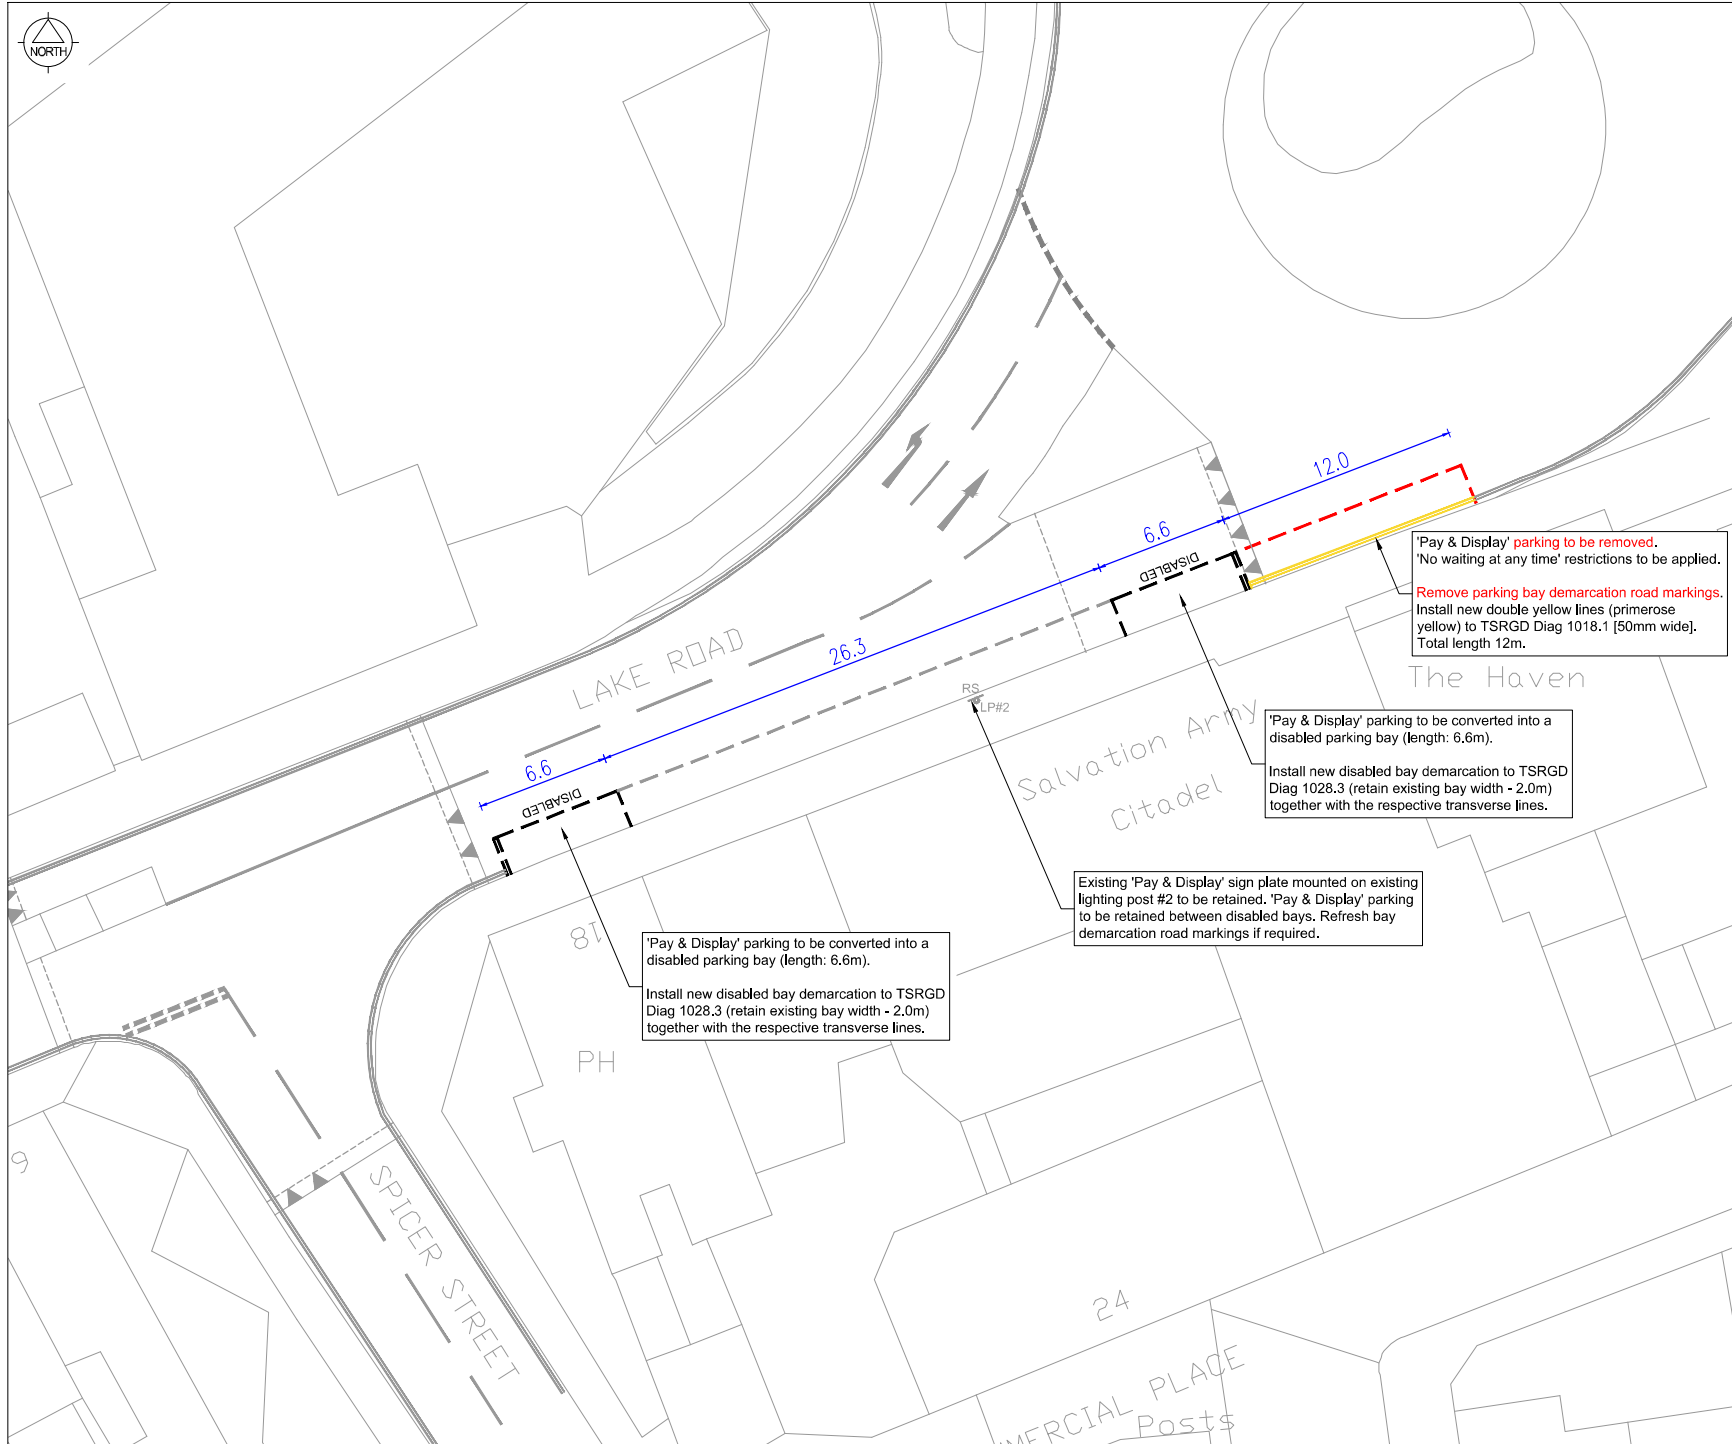

- General Notes:**
1. All dimensions in metres, unless otherwise stated. Dimensions to be checked prior to commencement of any work by Engineer on Site. Notify Engineer of any discrepancies before starting the works.
 2. All traffic signs and road markings are to be in accordance with the Traffic Signs Regulations and General Directions, 2016.
 3. Ordnance Survey Copy Right - Based or reproduced from the 2008 Ordnance Survey 1/10000 base with the permission of HMSO crown copyright reserved. License No. LA-100019671.
 4. Aerial images obtained from Google Earth imagery © 2023 CNES / Airbus, Getmapping plc, Infoterra Ltd & Bluesky, Landsat / Copernicus, Maxar Technologies, The GeoInformation Group, Map data © 2023.
 5. Do not scale from this drawing. Drawing to be printed in colour only.

FOR INFORMATION


A	30.11.23	Initial issue.	EA	FL
Rev	Date	Revision Details	Approved	Approved

Project

**Lake Road
Blue Badge Holder Bays**

Drawing Title

TRO Drawing

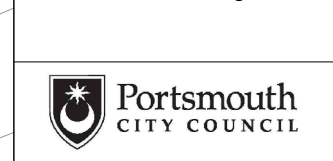

REGENERATION Assistant Director (Infrastructure) Martin Lavers BSc CEng MICE				
Date	November 2023	Scale	1:250 @ A3	
Design/Survey by	EA	Drawn by	EA	Checked by
Drawing No	HWI1290-TRO-01			Revision No.
	A			
FEASIBILITY		DRAFT		CONSTRUCTION
INFORMATION	*	TENDER		AS BUILT