


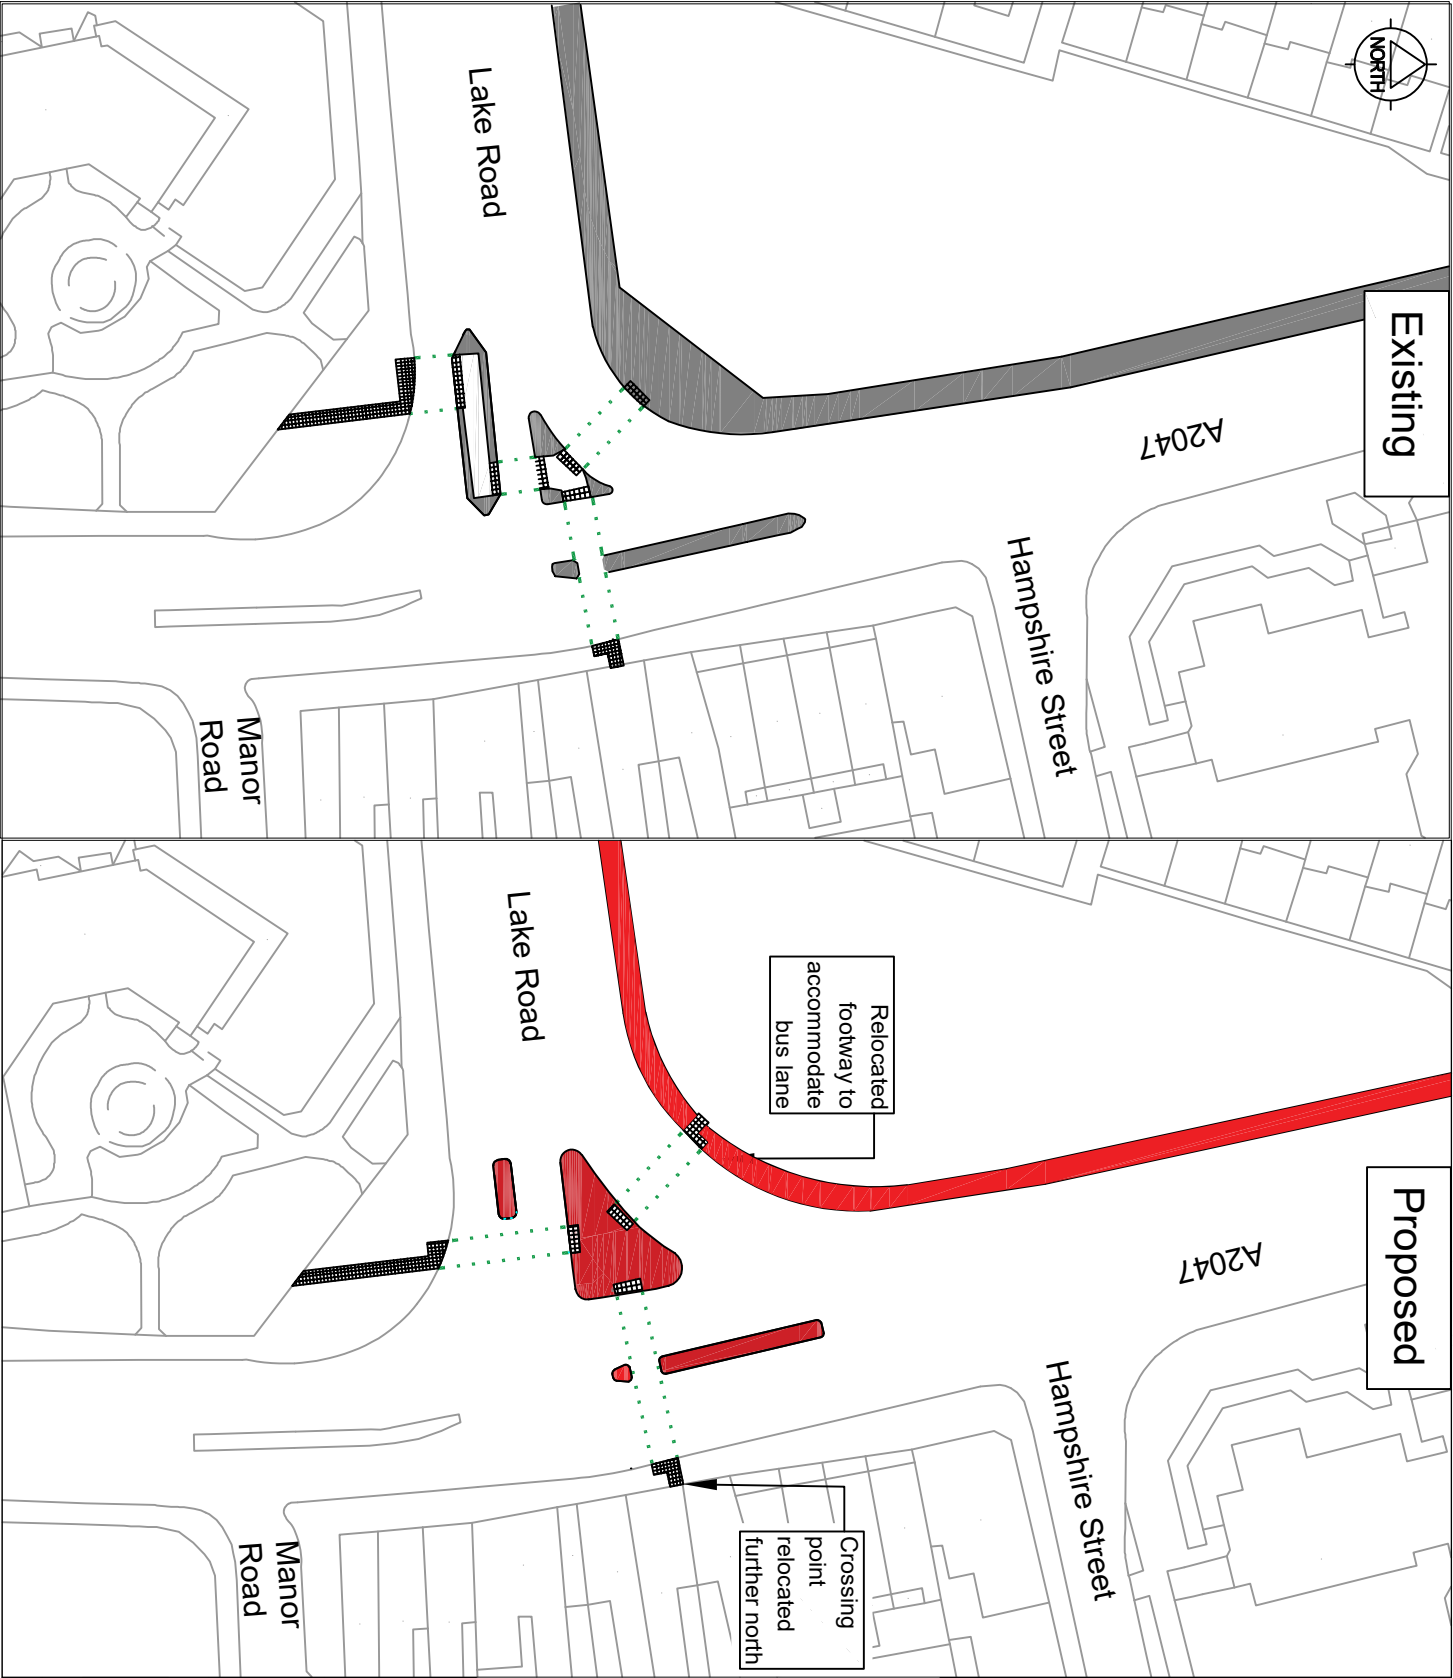

- Existing Layout
- Proposed Layout
- Crossing Route



Directorate of Economy, Planning and Transport					
Assistant Director (Infrastructure)					
Martin Lavers BSc CEng MICE					
Date	24/07/2025	Design/Survey by	RE	Drawn by	RE
Scale	NTS	Checked by	CM	Approved by	KS
Drawing No	P022-25 Consultation Plan				Revision No.
FEASIBILITY		DRAFT		CONSTRUCTION	
INFORMATION	*	TENDER		AS BUILT	